



ntrive

STRUCTURAL ENGINEERING

CHICAGO, IL

JOB BALCONY NO. 2015051

SHEET NO. _____ OF _____


CALCULATED BY SRU DATE 2/25/15

CHECKED BY _____ DATE _____

DESCRIPTION _____

THIS PLACES A HUGE AMOUNT OF FORCE INTO THE WALL, AND THEN INTO THE DIAPHRAGM. IT IS LIKELY THAT WE WILL HAVE TO ADD FULL HEIGHT STEEL TUBES IN THE WALL TO TAKE THE LOAD.

BASED ON 100 PSF LL

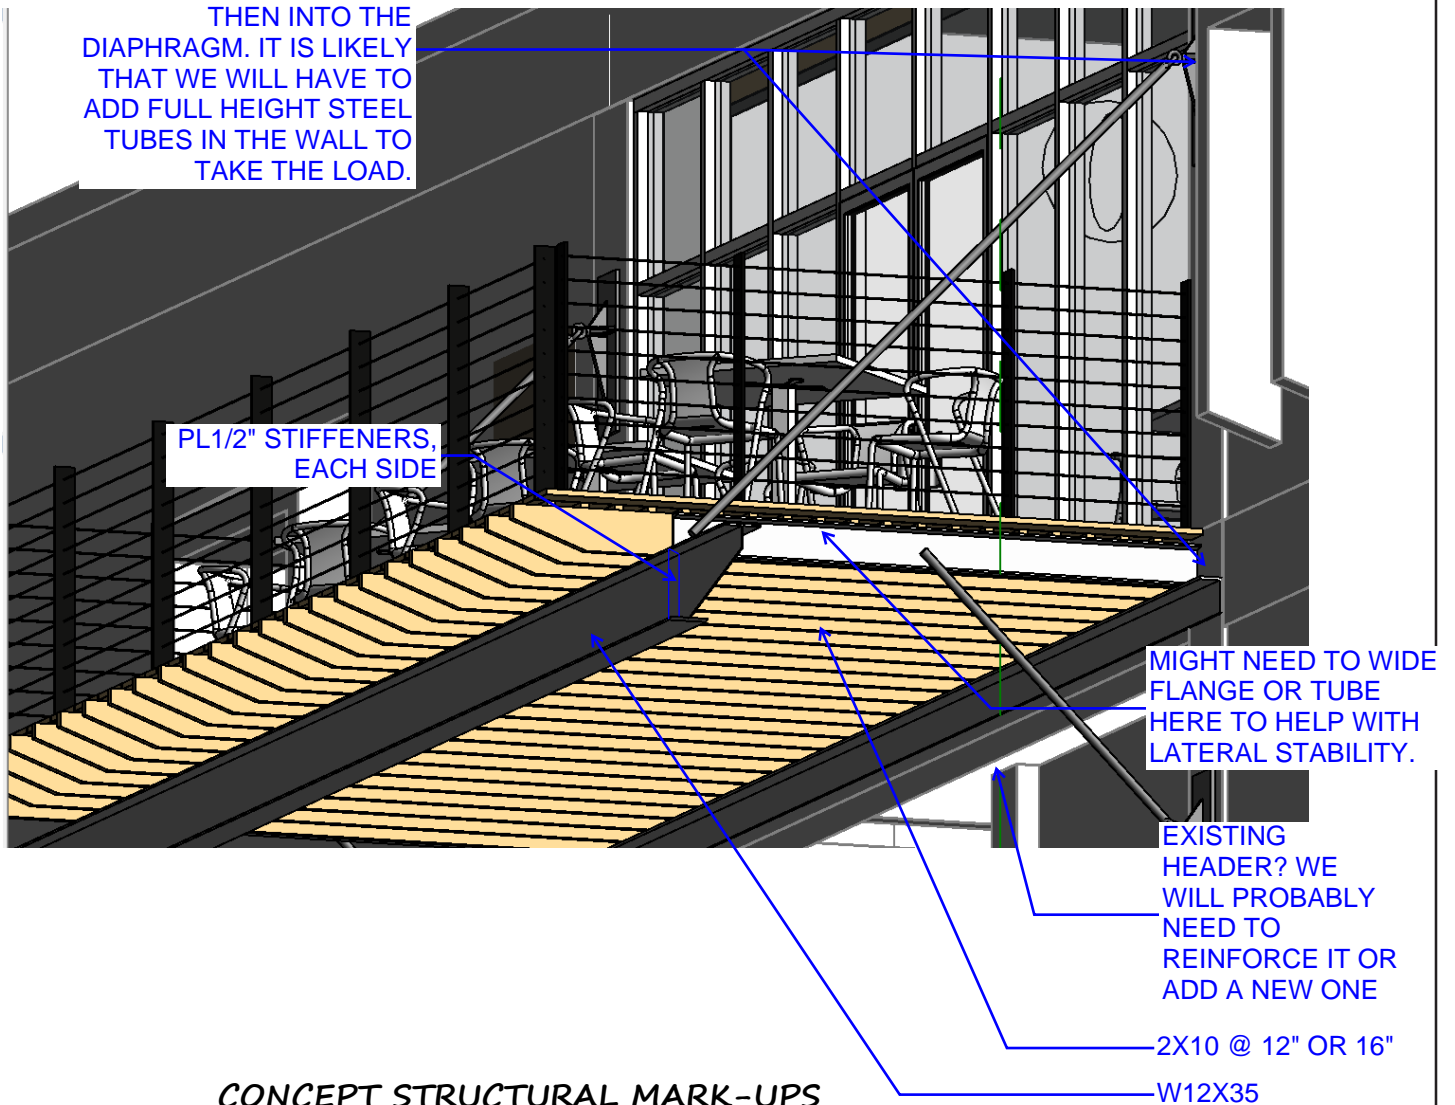

CONCEPT STRUCTURAL MARK-UPS